





TOPOGRAPHIC SKETCH OF
ZIBI PROJECT
ZEIDA PRIVATE AS BUILT
CITY OF OTTAWA
Stantec Geomatics Ltd.

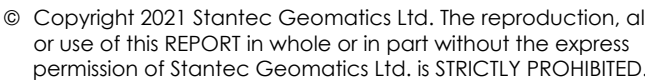

METRIC CONVERSION
DISTANCES AND COORDINATES SHOWN ON THIS PLAN ARE IN METRES AND CAN BE CONVERTED TO FEET BY DIVIDING BY 0.3048

ELEVATION NOTE
ELEVATIONS ARE GEODETIC AND ARE REFERRED TO A BOLT ON TOP OF THE CONCRETE CANAL WALL PER FAIRHALL, MOFFATT & WOODLAND LTD. TOPOGRAPHIC SURVEY DATED JANUARY 19, 2015.

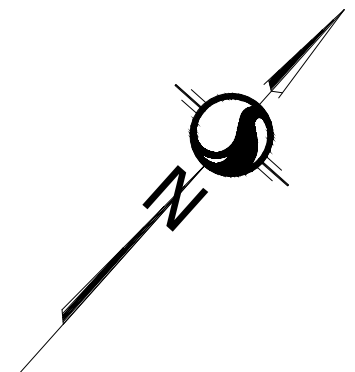

	ACU	AIR CONDITIONING UNIT
	AN	ANCHOR
	AP	AIR PUMP
	ANT	ANTENNA
	BH	BOREHOLE
	BOB	BOISE BB
	BKR	BIKE RACK
	BENCH	BENCH
	BOLL	BOLLARD
	BOUL	BOULDER
	CB	CATCH BASIN
	DCB	DOUBLE CB
	CBM	CB MANHOLE
	DCB/MH	DOUBLE CB MANHOLE
	SICB	SIDE INLET CB
	CHM	CHIMNEY
	CLEAN OUT	CLEAN OUT
	CURB STOP VALVE	CURB STOP VALVE
	DRAIN	DRAIN
	EPOST	ELECTRICAL OUTLET
	FP	FLAG POLE
	FLOO	FLOOD LIGHT
	FTT	FUEL TANK FILLER CAP
	GAR	GARBAGE CAN
	GFL	GPT FLANGE (GAS)
	GFP	GAS FUEL PUMP
	GP	POLE GUYPWIRE
	GSR	GAS SERVICE REGULATOR
	GV	GAS VALVE
	HICKENB	HICKENSBOTTOM
	HDS	HEADSTONE
	HLS	HYDRO LIGHT STANDARD
	HYDRO METER	HYDRO METER
	HYDRO TRANSFORMER	HYDRO TRANSFORMER
	HW	HAND WELL
	HYD RANT	HYD RANT
	JBN	JUNCTION BOX
	LS	LIGHT STANDARD
	MALB	MALBOX
	MONITORING PIN	MONITORING PIN
	MH	MAINTENANCE HOLE
	MHU	MAINTENANCE HOLE IDENTIFIER
	MHF	MAINTENANCE HOLE FIBRE OPTIC
	MH	MAINTENANCE HOLE HYDRO
	MHSS	MAINTENANCE HOLE SANITARY
	MAHST	MAINTENANCE HOLE STORM
	MH	MAINTENANCE HOLE TRAFFIC
	MONITORING WELL	MONITORING WELL
	NWP	NEWS PAPER BOX
	OL	LIGHT STANDARD ORNAMENTAL
	OW	OBSERVATION WELL
	PARKING METER	PARKING METER
	PLBX	PULL BOX
	PLO	PLAQUE
	PZ	PILLAR
	PIEDMETER	PIEDMETER
	RED LIGHT CAMERA	RED LIGHT CAMERA
	RWSL	RAILWAY SIGNAL
	RAH	RAILWAY SWITCH STAND
	SCL	SATELLITE DISH
	SCPY	SCULPTURE
	SOP	SUMP/CATCH PIT
	SPRINKLER CONTROL VALVE	SPRINKLER CONTROL VALVE
	SPRINKLER HEAD	SPRINKLER HEAD
	SI	SIAMESE CONNECTION
	SN	SIGN
	SOLAR PANEL	SOLAR PANEL
	SEPTIC TANK LID	SEPTIC TANK LID
	TAB	TABLE
	TERMINAL BOX - BELL	TERMINAL BOX - BELL
	TERMINAL BOX - CABLE	TERMINAL BOX - CABLE
	TRAFFIC CONTROL BOX	TRAFFIC CONTROL BOX
	TEST PIT	TEST PIT
	TRAFFIC SIGNAL LIGHT	TRAFFIC SIGNAL LIGHT
	MARKER BELL UNDERGROUND	MARKER BELL UNDERGROUND
	MARKER CABLE UNDERGROUND	MARKER CABLE UNDERGROUND
	MARKER GAS UNDERGROUND	MARKER GAS UNDERGROUND
	MARKER OIL UNDERGROUND	MARKER OIL UNDERGROUND
	UTILITY POLE	UTILITY POLE
	VALVE BOX	VALVE BOX
	VALVE CHAMBER	VALVE CHAMBER
	WATER VALVE	WATER VALVE
	TREE STUMP	TREE STUMP
	TREE CONIFEROUS (D.B.H. SHOWN)	TREE CONIFEROUS (D.B.H. SHOWN)
	TREE DECIDUOUS (D.B.H. SHOWN)	TREE DECIDUOUS (D.B.H. SHOWN)

SURVEYOR'S CERTIFICATE
I CERTIFY THAT :
1. THE SURVEY WAS COMPLETED ON THE 18TH DAY OF JANUARY, 2021.

DATE _____ BRIAN J. WEBSTER
ONTARIO LAND SURVEYOR