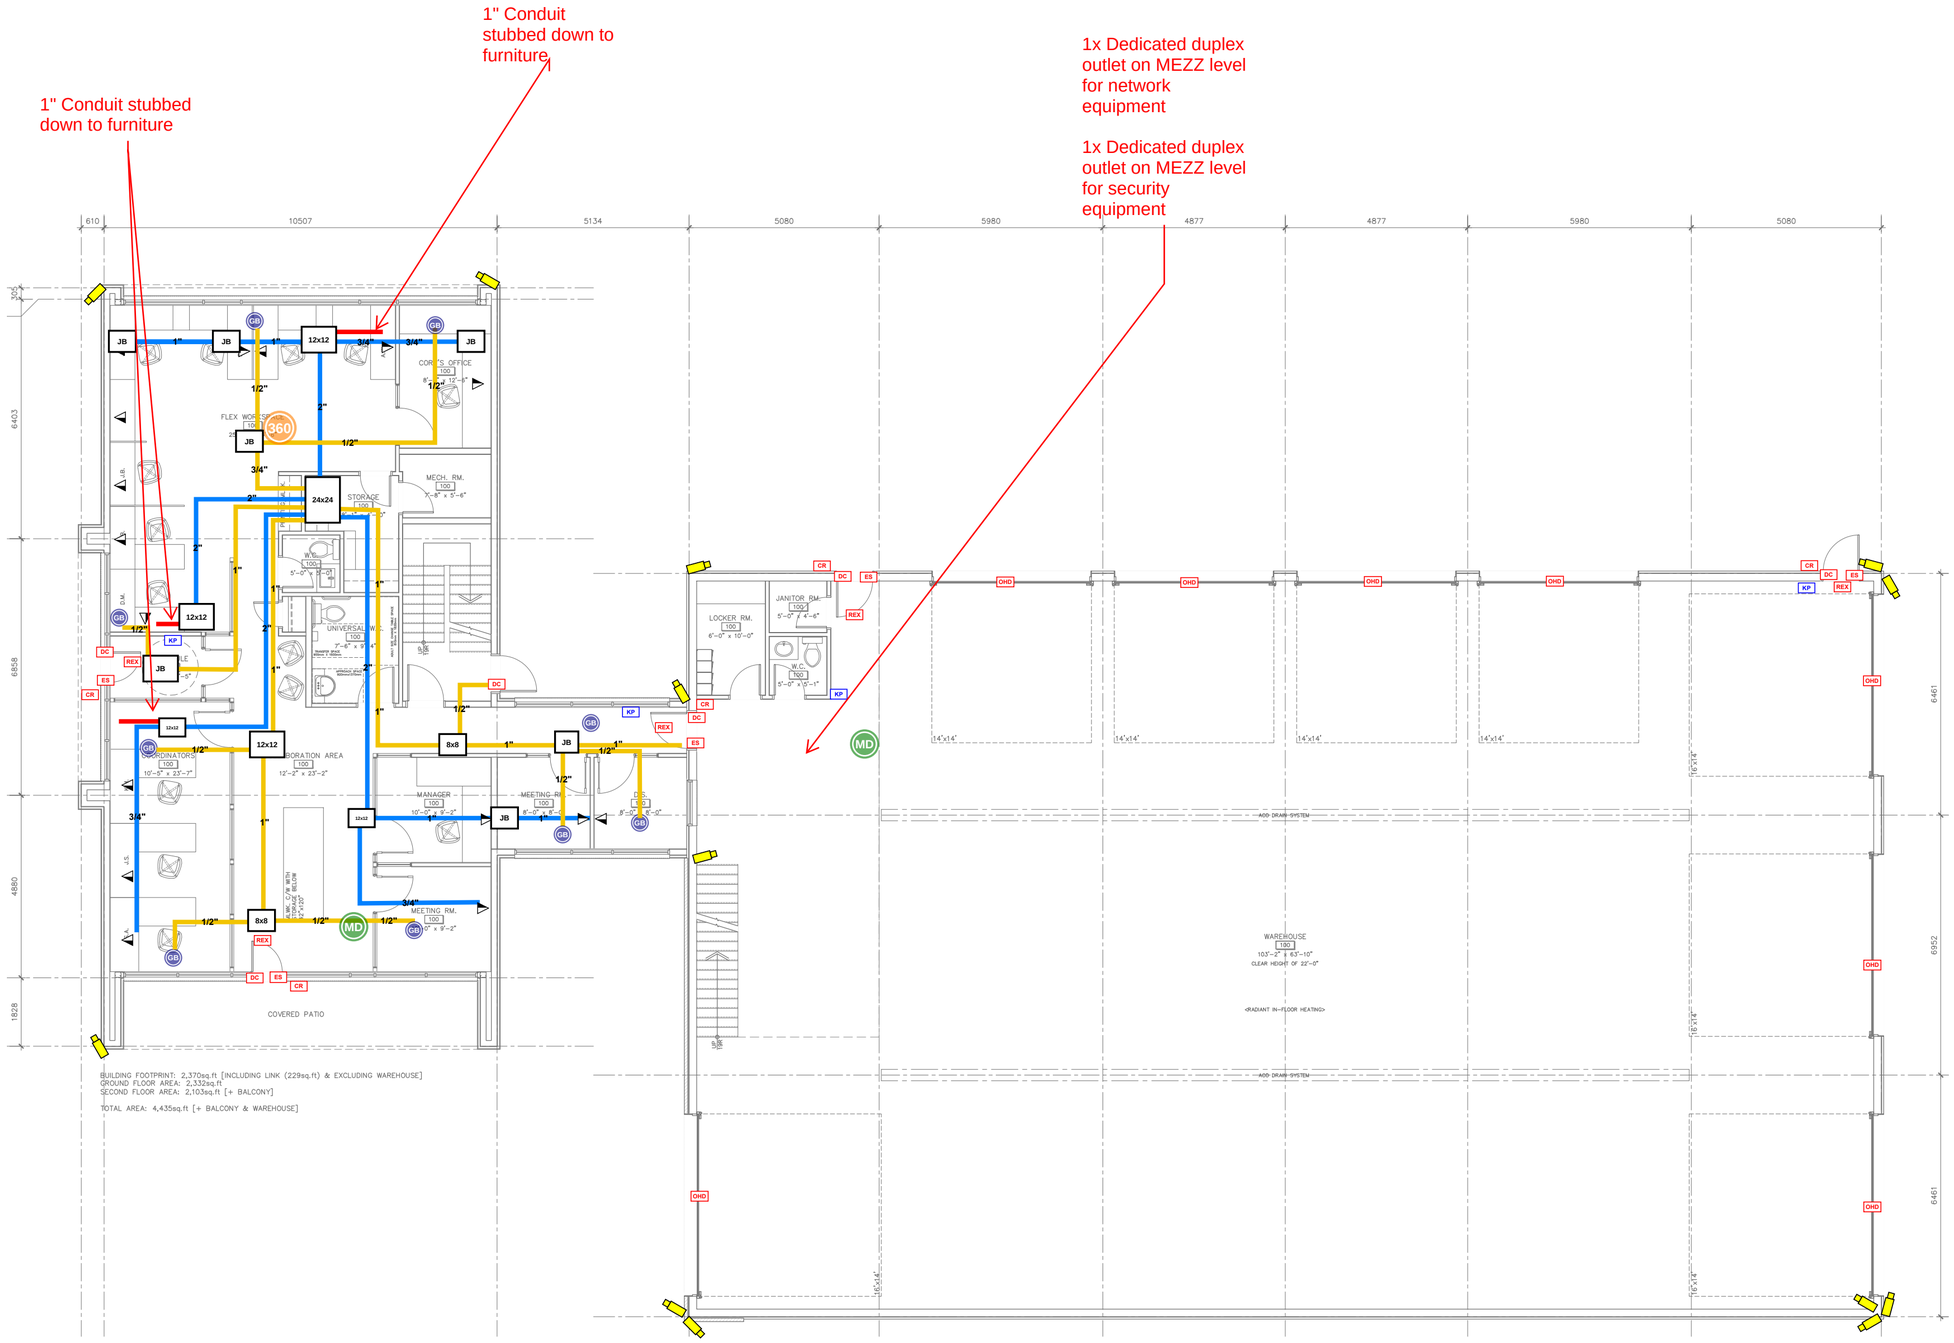

This marked up drawing is intended as an aid in the design of the communication, security and wireless portions of this project. Parts of this drawing may be composed of elements from other drawings diagrams. FCi is not responsible for E/O as a result of this package.

This drawing isn't intended for use in tendering or construction.

Legend

Description	Quantity
360 Motion Detector	1
Alarm Keypad	4
Card Reader	5
CCTV	13
Door Contact	6
Electric Strike	5
Glass Break Sensor	9
Motion Detector	2
Overhead Door Contact	8
Request to Exit	5
3/4" SIZE	5
2" SIZE	5
1/2" SIZE	11
1" SIZE	12

REVISION No.	DESCRIPTION	DATE
1	Design	10/20

PROJECT:

Cityscape Commercial Warehouse
144 Bentley Avenue
Ottawa, ON

DRAWING:

Security Design
Ground Floor

DATE: 7/10/20

De. by: SM

Dr. by: SM

Ch. by:

SCALE: **NTS**

No. DWGS. 1 of 2

Quote No.

DRAWING No.

S-100

All data outlets will be cabled from below. Conduits are identified on the previous floor plans and conduits will penetrate the floor from below in order to make the required connections.

1x 15amp duplex outlet for network equipment

1x 15amp duplex outlet for security equipment

3/4" Conduit required between projector and wall mounted screen/TV

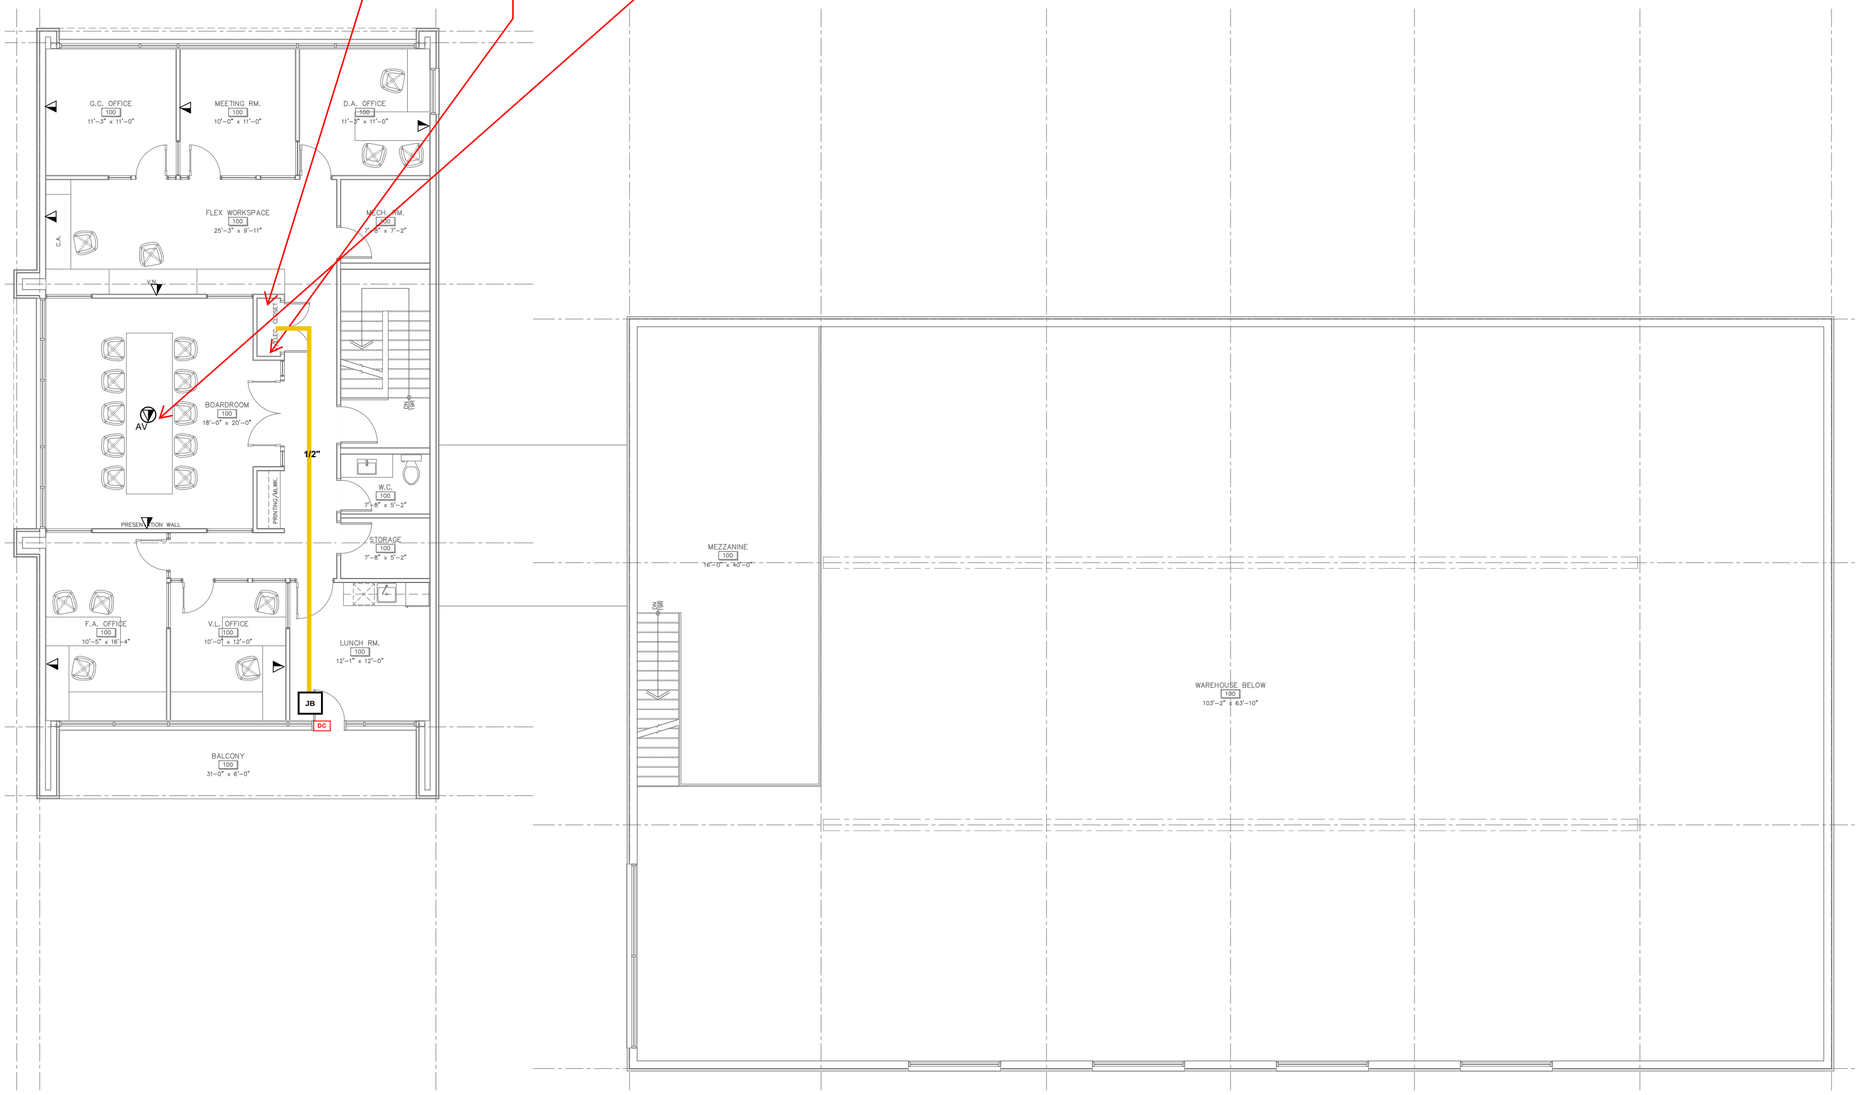

This marked up drawing is intended as an aid in the design of the communication, security and wireless portions of this project. Parts of this drawing may be composed of elements from other drawings diagrams. FCi is not responsible for E/O as a result of this package.

This drawing isn't intended for use in tendering or construction.

Legend

Description	Quantity
DC Door Contact	1

REVISION No.	DESCRIPTION	DATE
1	Design	10/20

PROJECT:

Cityscape Commercial Warehouse
144 Bentley Avenue
Ottawa, ON

DRAWING:

Security Design
Upstairs

DATE: 7/10/20

De. by: SM

Dr. by: SM

Ch. by:

SCALE: **NTS**

No. DWGS. 2 of 2

Quote No.

DRAWING No.

S-101